

Notice of Discontinuation

Company: KYCON, Inc. 305 Digital Dr. Morgan Hill, CA 95037 USA 408-494-0330

3/6/2023

Re: **EOL**

Part Number: STX-3150-5N-577C; STX-3150-5N-701C


Please note that the above part numbers are EOL due to worn tooling.

Engineering has approved an alternate part.

Please contact your Kycon Sales Representatives for details.

Alternate part numbers: STX-3150-5N-577C-1 STX-3150-5N-701C-1

Redline drawing attached

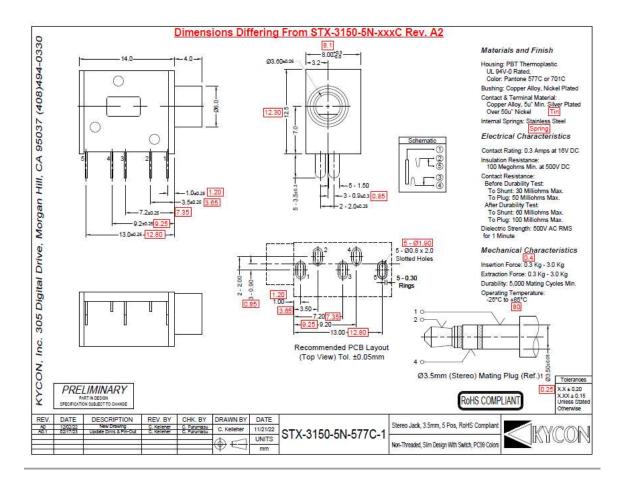

Please contact your Kycon sales representative if you require more information.

Signature:

Name: Jill Scarnecchia

Phone: 408-494-0330